


I CERTIFY THAT THIS PLAN SHOWS THE UNIT BEING CONVEYED AND IMMEDIATELY ADJOINING UNITS AS BUILT WITH APPROXIMATE BUILDING AREA, MAIN ENTRANCE, AND IMMEDIATE COMMON AREAS TO WHICH IT HAS ACCESS AND CONFORMING WITH THE RULES AND REGULATIONS OF THE REGISTERS OF DEEDS IN PREPARING THE PLAN

BERNARD J. GOBA, AIA

DATE

1/8" = 1'-0"
 15 FT. 10 5 0
 UNIT ANALYSIS
 958 SQ. FT.
 11.7% FLOOR OWNERSHIP

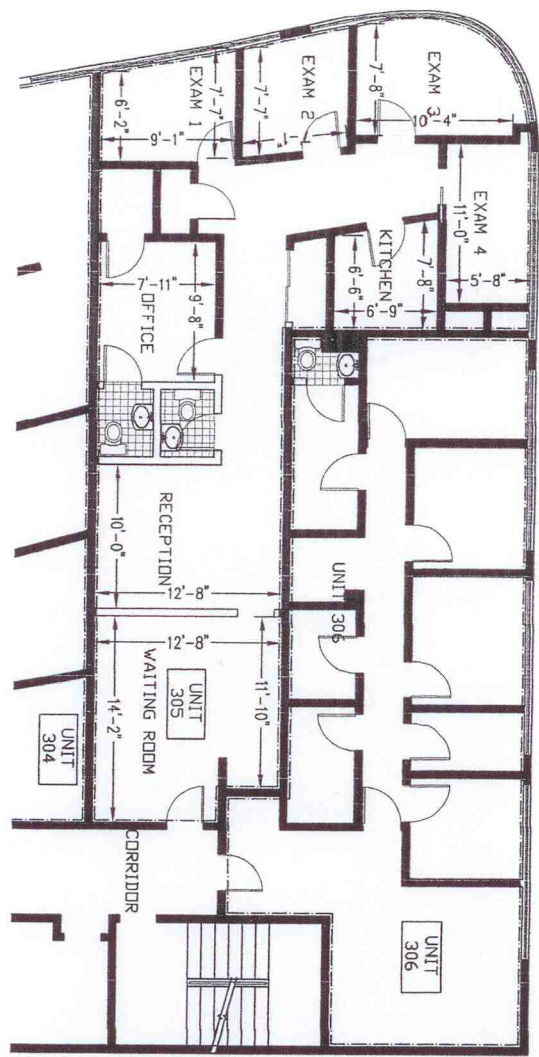

THIRD FLOOR UNIT 305 <small>1/8" = 1'-0"</small> DRAWN BY: RDH CHECKED BY: BC		DATE PLOTTED: MAY 4, 2008	BEACON 1842 CONDOMINIUM TRUST 1842 BEACON STREET BROOKLINE, MA	B. GOBA & C. ARCHITECTS 92 STATE STREET BROOKLINE, MA (781) 235-2827
---	--	------------------------------	--	--